Ashford and St. Peter's Hospitals
NHS Foundation Trust

Capital Development Update

September 2023

Improving access to main theatres
Courtyard
PROPOSED LIFT TOWER LAYOUT PLAN
Store
Lift
Plant
Store/Regen Kit 11 m²
Bariatric Lift 12 m²
Bariatric Lift 12 m²
Lift Lobby 31 m²
En-suite 7 m²
Bay
Delivery Room 22 m²
En-suite 7 m²
Storage 10 m²
En-suite 7 m²
Delivery Room 22 m²
Storage 10 m²
2000
2500
2350
4200
4900
3300
3500
2300
2700
3600
2640
2750
2220
PROJECT TITLE
Abbey Wing Development
BDP JOB NUMBER
P3001762
DATE
03/22/23
SKETCH TITLE
Lift Layout
Sketch No.
AW-01-SK-A-200015
DRAWN BY
Author
BDP.

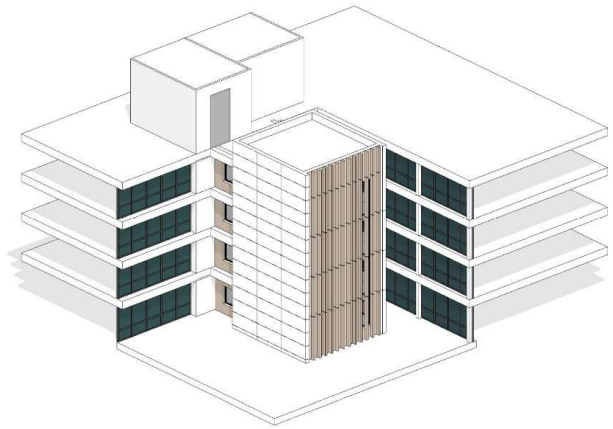

1. Textured White Fibre Cement Rainscreen Cladding
2. Vertical Coloured Metal Fins

WHITE CLADDING OPTION

PROJECT TITLE
Abbey Wing - Lift Study

BDP JOB NUMBER
P3001762

DATE
03/22/23

SKETCH TITLE
Fin Option

Sketch No.
XX-XX-XX-A-100001

DRAWN BY
PS

BDP.

Ashford Hospital

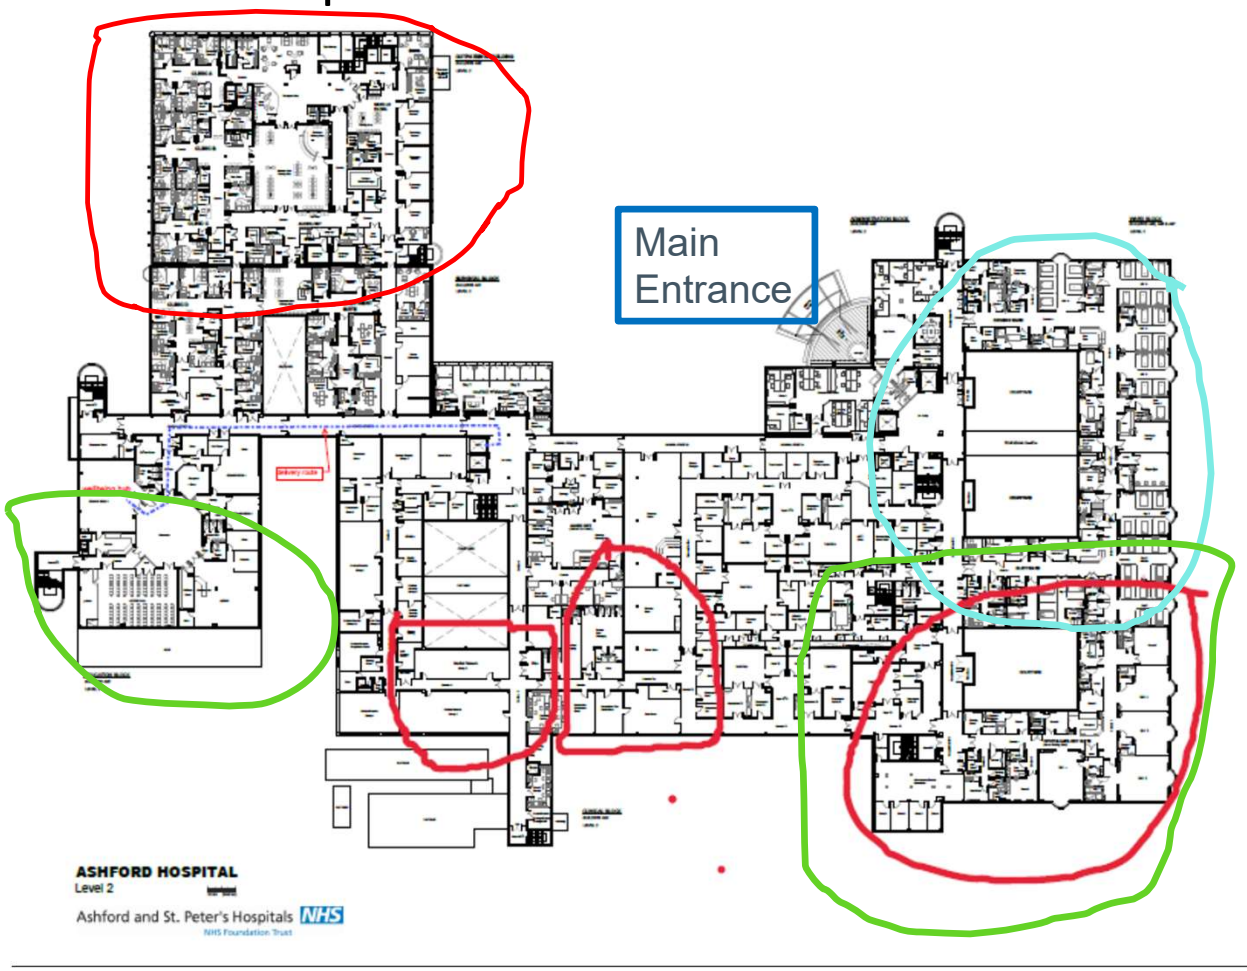

Surrey Heartlands Elective Surgery Centre

Level 3 (Top floor)
2 Theatre Ophthalmology suite
Ophthalmology on one floor

Level 2
2 new main theatres
Potential
New Admissions/Recovery Ward
Bariatric clinic in expanded Outpatient clinics

Level 1 (Ground floor)
Pre-operative Assessment
Phlebotomy
Paediatric Outpatients
Re-organised storage

Level 2
2 new Main theatres

J	Pre-Assessment room amendment	EA MA	16/08/2022
H	General amendments	EA MA	11/08/2022
G	Minor amendments	EA MA	14/06/2022
F	General amendments	EA MA	11/06/2022
E	ITA Stage 2 Issue	EA MA	01/06/2022
D	Minor amendments	MA MA	18/07/2022
C	Minor amendments	EA MA	12/07/2022
B	General amendments	EA MA	11/07/2022
A	First Issue	EA MA	24/06/2022

SUITABILITY CODE: S4 - Approval

STAGE: RIBA Stage 2

Subject to site surveys
Not to be used for construction.
Read alongside:
- all other Floyd Slaski proposals and reports.
- demolition schedules.
- all other existing building information.
- all other design information by others.

Where CAD and BIM files of drawings are issued for coordination purposes, they are
- not to be used in full or in part for any reason on any project other than that shown on this title block.
- provided for convenience and shall not be used for construction purposes or relied upon for accuracy or completeness.

The accuracy of information supplied or commissioned by the client remains the responsibility of the client, including:
- record drawings and documents
- operations and maintenance manuals
- health and safety files
- survey information

The Copyright in this drawing belongs to Floyd Slaski Architects Ltd.
Not to be used or reproduced without Floyd Slaski Architects Ltd consent.

www.floydslaski.co.uk
39-43 Putney High Street
London SW15 1SP
+44 (0)20 3840 2468

FLOYD SLASKI ARCHITECTS

Project: Ashford Ophtalmology Centre

Title: Proposed second floor (Level 03) - Plan

Client: Ashford and St Peter's Hospitals NHS

Project number	Drawing number	Scale @ A1
5559	02130	1 : 100

Drawing number: 5559- FLO- AOC- 02- DR- A- 02130 — J

Woking Community Hospital
Community diagnostic Centre (CDC)
Layout subject to final design and planning

Ashford Macmillan Centre
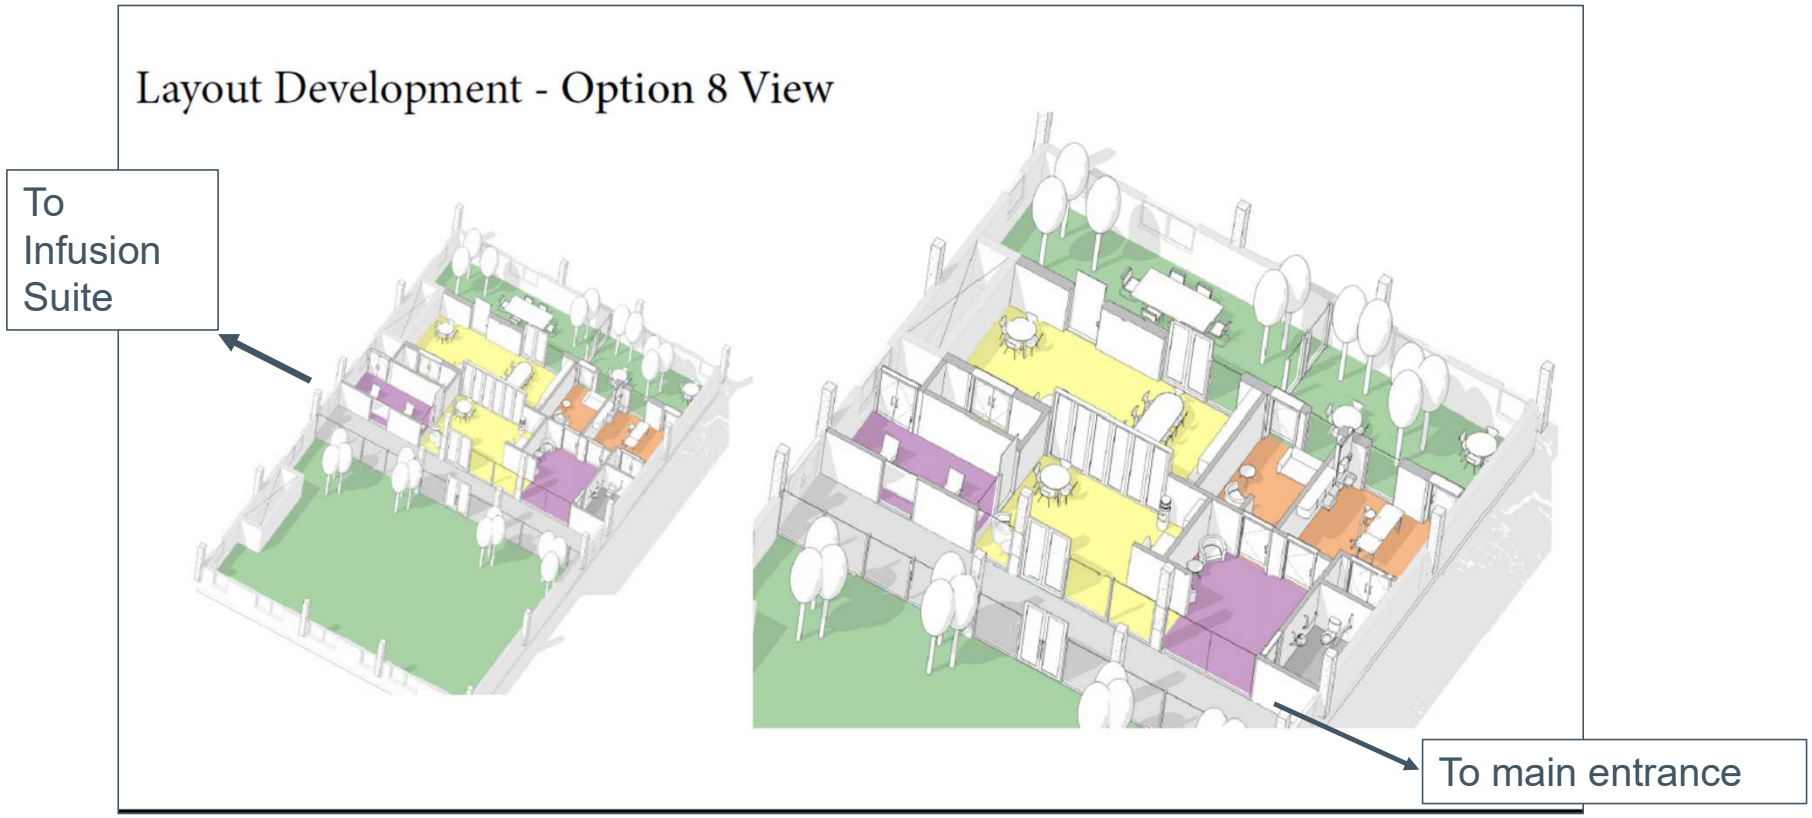
The works expected to start in spring of 2024 after the completion of the Surgical Centre works.